

Legend	Property Line
Water Main	Water Main
Water Sewer	Water Sewer
Sanitary Sewer	Sanitary Sewer
Storm Sewer	Storm Sewer
Electric	Electric
Gas	Gas
Telephone	Telephone
Fire Hydrant	Fire Hydrant
Valve	Valve
Manhole	Manhole
Structure	Structure
Other	Other

Laconia
Belmont

Redacted

NOT TO SCALE
THIS PLAN IS A PRELIMINARY DESIGN AND IS NOT TO BE USED FOR CONSTRUCTION. IT IS THE RESPONSIBILITY OF THE ENGINEER TO PROVIDE THE NECESSARY INFORMATION TO THE CLIENT. THE CLIENT IS RESPONSIBLE FOR OBTAINING ALL NECESSARY PERMITS AND APPROVALS. THE ENGINEER'S OFFICE IS NOT RESPONSIBLE FOR ANY ERRORS OR OMISSIONS. THE CLIENT IS RESPONSIBLE FOR OBTAINING ALL NECESSARY PERMITS AND APPROVALS. THE ENGINEER'S OFFICE IS NOT RESPONSIBLE FOR ANY ERRORS OR OMISSIONS.

DATE: 1/24/2010

Composite Water and Sewer Plan FOR Lakeland Management, Inc Belmont, Belknap County, New Hampshire Scale: 1" = 100' Date: 1-24-2010

DATE	1/24/2010
BY	XXX
CHECKED BY	XXX
APPROVED BY	XXX
SCALE	1" = 100'
DATE	1/24/2010

ABENAKI WATER COMPANY



**37 NORTHWEST DRIVE
PLAINVILLE, CONNECTICUT 06062
860-747-1665**



SYSTEM LOCATION

**WHITE ROCK WATER SYSTEM
BOW, NEW HAMPSHIRE**

**SYSTEM RECORD DRAWINGS
2019**

- BLOW OFF
- ⊗ CURB STOP
- ⛔ GATE VALVE
- WATER MAIN
- - - SERVICE LINE
- - - PROPERTY LINES

SOUTH ROAD

3

 
375

371


365

363

Redacted



NOTE: THIS PLAN WAS REPRODUCED
FROM A LOCATION PLAN ENTITLED, "TIOGA
RIVER WATER COMPANY, INC." (UNDATED),
AND SUBSEQUENT HANDWRITTEN REVISIONS
TO THE SAME.

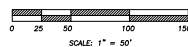

ABENAKI WATER COMPANY

SCALE: 1" = 50'	DRAWN BY: RG
DATE: 09/08/2021	REVIEWED: RG
TIOGA RIVER, BELMONT WATER SYSTEM RECORD DRAWING	
WATER PLAN	DRAWING FILE: -
	DRAWING NO: 1

ABENAKI WATER COMPANY



**37 NORTHWEST DRIVE
PLAINVILLE, CONNECTICUT 06062
860-747-1665**




SYSTEM LOCATION

**TIOGA-GILFORD VILLAGE
GILFORD, NEW HAMPSHIRE**

**SYSTEM RECORD DRAWINGS
2021**

Redacted

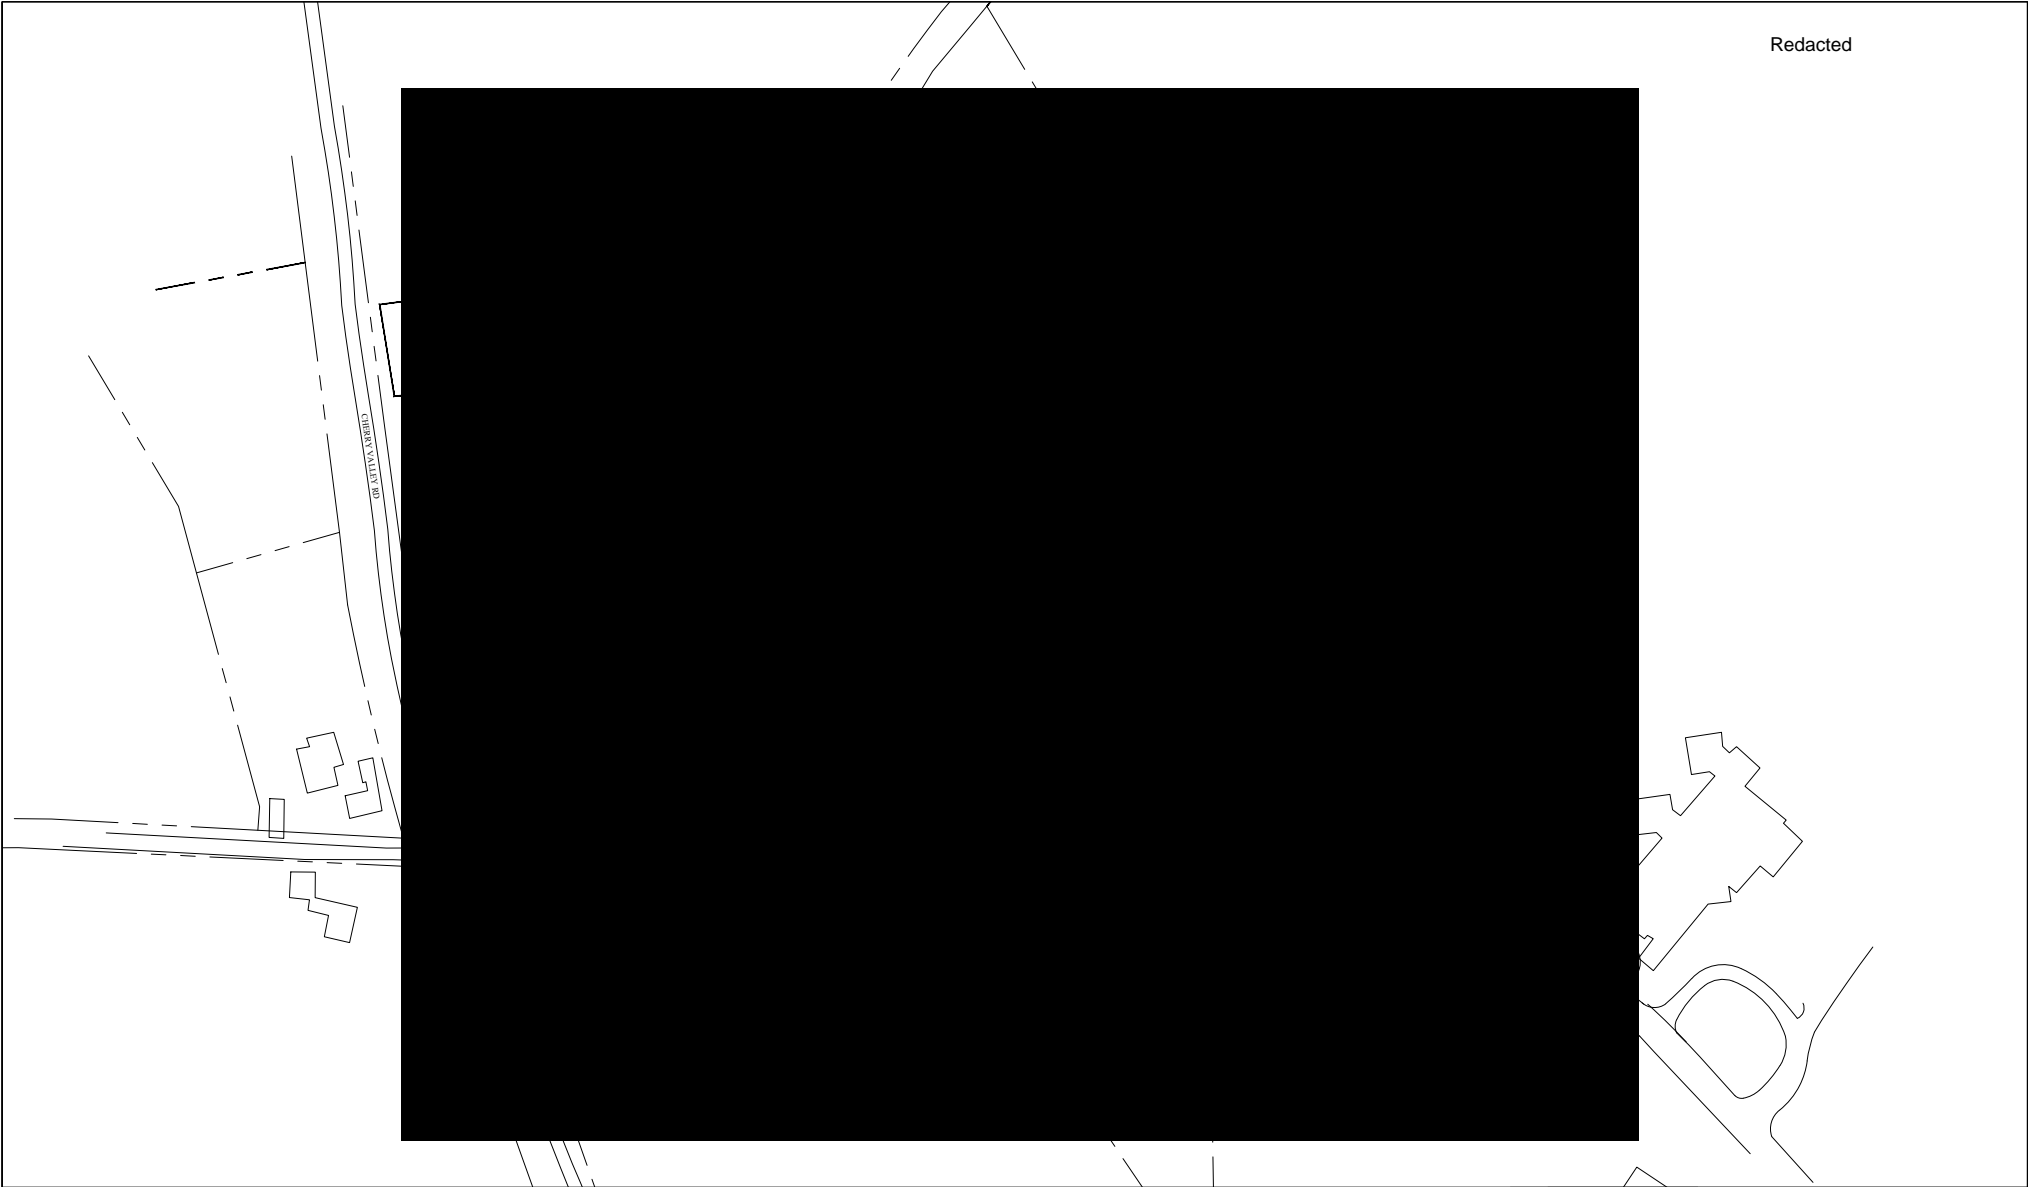

NOTE: THIS PLAN WAS REPRODUCED FROM A PLAN ENTITLED, "GILFORD VILLAGE WATER SYSTEM - WATER MAIN REPLACEMENT", BY THE TOWN OF GILFORD ENGINEERING DEPARTMENT, DATED JULY 13, 1972. ADDITIONAL INFORMATION IS BASED ON OBSERVATIONS FROM FIELD OPERATIONS.



TIOGA-GILFORD VILLAGE
WATER SYSTEM

SCALE: 1" = 1'	DRAWN BY: RG
DATE: 2021	CHECKED BY: EM/RG

WATER SYSTEM RECORD DRAWINGS

DRAWING FILE:
DRAWING NO.: 1 of 8


MATCH LINE DWG NO. 6

ROUTE 11A

2


ROUTE 11A

NOTE: THIS PLAN WAS REPRODUCED FROM A
PLAN ENTITLED, "GILFORD VILLAGE WATER
SYSTEM - WATER MAIN REPLACEMENT", BY THE
TOWN OF GILFORD ENGINEERING DEPARTMENT,
DATED JULY 13, 1972. ADDITIONAL
INFORMATION IS BASED ON OBSERVATIONS
FROM FIELD OPERATIONS.

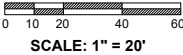


WATER SYSTEM	
SCALE: 1" = 20'	DRAWN BY: RG
DATE: 2021	CHECKED BY: EM/RG
WATER SYSTEM RECORD DRAWINGS	
DRAWING FILE:	
DRAWING NO.: 1 of 8	



 



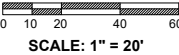





NOTE: THIS PLAN WAS REPRODUCED FROM A
PLAN ENTITLED, "GILFORD VILLAGE WATER
SYSTEM - WATER MAIN REPLACEMENT", BY THE
TOWN OF GILFORD ENGINEERING DEPARTMENT,
DATED JULY 13, 1972. ADDITIONAL
INFORMATION IS BASED ON OBSERVATIONS
FROM FIELD OPERATIONS.




TIOGA-GILFORD VILLAGE WATER SYSTEM	
SCALE: 1" = 20'	DRAWN BY: RG
DATE: 2021	CHECKED BY: EM/RG
WATER SYSTEM RECORD DRAWINGS	
DRAWING FILE:	
DRAWING NO. 3 of 8	

Redacted

-  HYDRANT
-  CURB STOP
-  GATE VALVE
-  WELL
-  METER PIT
-  WATER MAIN
-  SERVICE LINE
-  PROPERTY LINE

NOTE: THIS PLAN WAS REPRODUCED FROM A
PLAN ENTITLED, "GILFORD VILLAGE WATER
SYSTEM - WATER MAIN REPLACEMENT", BY THE
TOWN OF GILFORD ENGINEERING DEPARTMENT,
DATED JULY 13, 1972. ADDITIONAL
INFORMATION IS BASED ON OBSERVATIONS
FROM FIELD OPERATIONS.

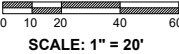

TIOGA-GILFORD VILLAGE WATER SYSTEM	
SCALE: 1" = 20'	DRAWN BY: RG
DATE: 2021	CHECKED BY: EM/RG
WATER SYSTEM RECORD DRAWINGS	
DRAWING FILE:	
DRAWING NO. 4 of 8	


Redacted

15

PROPERTY LINE
EDGE OF ROAD

- HYDRANT
- CURB STOP
- GATE VALVE
- WELL
- METER PIT
- WATER MAIN
- SERVICE LINE
- PROPERTY LINE



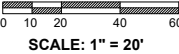





NOTE: THIS PLAN WAS REPRODUCED FROM A
PLAN ENTITLED, "GILFORD VILLAGE WATER
SYSTEM - WATER MAIN REPLACEMENT", BY THE
TOWN OF GILFORD ENGINEERING DEPARTMENT,
DATED JULY 13, 1972. ADDITIONAL
INFORMATION IS BASED ON OBSERVATIONS
FROM FIELD OPERATIONS.



TIOGA-GILFORD VILLAGE WATER SYSTEM	
SCALE: 1" = 20'	DRAWN BY: RG
DATE: 2021	CHECKED BY: EM/RG
WATER SYSTEM RECORD DRAWINGS	
DRAWING FILE:	
DRAWING NO. 5 of 8	


MATCH LINE

Redacted

-  HYDRANT
-  CURB STOP
-  GATE VALVE
-  WELL
-  METER PIT
-  WATER MAIN
-  SERVICE LINE
-  PROPERTY LINE

MATCH LINE


NOTE: THIS PLAN WAS REPRODUCED FROM A
PLAN ENTITLED, "GILFORD VILLAGE WATER
SYSTEM - WATER MAIN REPLACEMENT", BY THE
TOWN OF GILFORD ENGINEERING DEPARTMENT,
DATED JULY 13, 1972. ADDITIONAL
INFORMATION IS BASED ON OBSERVATIONS
FROM FIELD OPERATIONS.

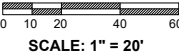







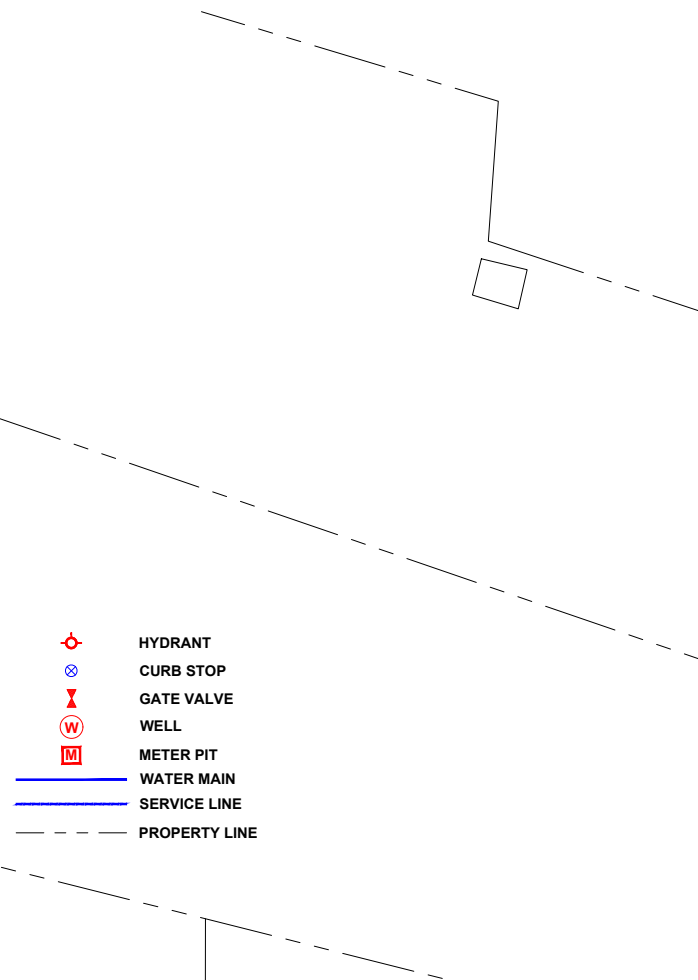

TIOGA-GILFORD VILLAGE WATER SYSTEM	
SCALE: 1" = 20'	DRAWN BY: RG
DATE: 2021	CHECKED BY: EM/RG
WATER SYSTEM RECORD DRAWINGS	
DRAWING FILE:	
DRAWING NO. 5 of 8	

MATCH LINE DWG NO. 8


Redacted



-  HYDRANT
-  CURB STOP
-  GATE VALVE
-  WELL
-  METER PIT
-  WATER MAIN
-  SERVICE LINE
-  PROPERTY LINE

MATCH LINE DWG NO. 6

NOTE: THIS PLAN WAS REPRODUCED FROM A PLAN ENTITLED, "GILFORD VILLAGE WATER SYSTEM - WATER MAIN REPLACEMENT", BY THE TOWN OF GILFORD ENGINEERING DEPARTMENT, DATED JULY 13, 1972. ADDITIONAL INFORMATION IS BASED ON OBSERVATIONS FROM FIELD OPERATIONS.

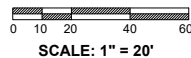









TIOGA-GILFORD VILLAGE
WATER SYSTEM

SCALE: 1" = 20'	DRAWN BY: RG
DATE: 2021	CHECKED BY: EM/RG

WATER SYSTEM RECORD DRAWINGS

DRAWING FILE:
DRAWING NO. 7 of 8

-  HYDRANT
-  CURB STOP
-  GATE VALVE
-  WELL
-  METER PIT
-  WATER MAIN
-  SERVICE LINE
-  PROPERTY LINE

WELL #4 (OFF SHEET)

Redacted

41

NOTE: THIS PLAN WAS REPRODUCED FROM A PLAN ENTITLED, "GILFORD VILLAGE WATER SYSTEM - WATER MAIN REPLACEMENT", BY THE TOWN OF GILFORD ENGINEERING DEPARTMENT, DATED JULY 13, 1972. ADDITIONAL INFORMATION IS BASED ON OBSERVATIONS FROM FIELD OPERATIONS.

0 10 20 40 60
SCALE: 1" = 20'




GILFORD VILLAGE
WATER SYSTEM

SCALE: 1" = 20'	DRAWN BY: RG
DATE: 2021	CHECKED BY: EM/RG


WATER SYSTEM RECORD DRAWINGS

DRAWING FILE:
DRAWING NO. 8 of 8

- HYDRANT
- CURB STOP
- GATE VALVE
- PRESSURE REDUCER
- WATER MAIN
- SERVICE LINE
- PROPERTY LINES
- ROADS

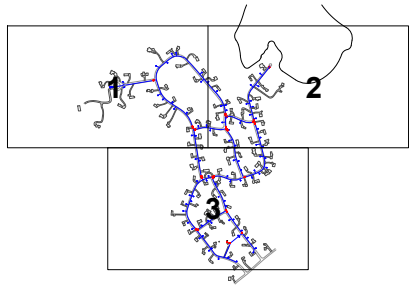


KEY PLAN
1:1000

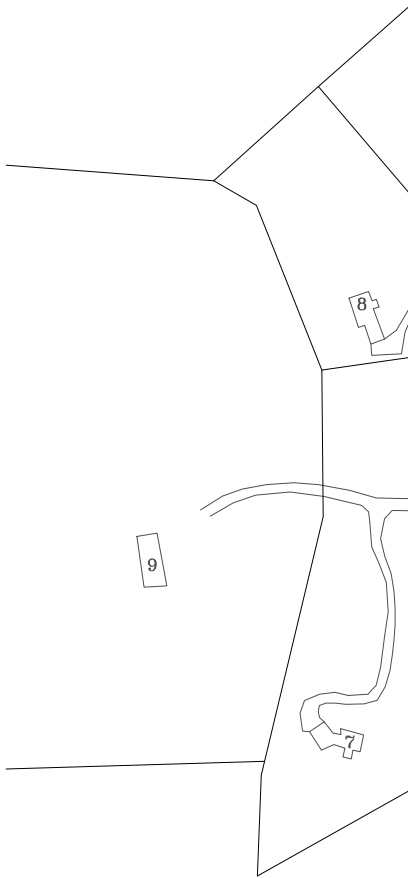

MATCH

NOTE: THESE DRAWINGS WERE PRODUCED
USING HARDCOPY MAPS PROVIDED BY OTHERS.
THE LOCATION INFORMATION SHOWN HAS NOT
BEEN LOCATED BY SURVEY.

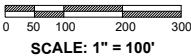

ABENAKI WATER COMPANY

SCALE: 1" = 100'

DRAWN BY: LHB

DATE: AUGUST 2019

CHECKED BY: RJG









WHITE ROCK SYSTEM MAPPING


DRAWING FILE:

DRAWING NO.: 1 OF 3

MATCH LINE DWG NO. 1

Redacted

-  HYDRANT
-  CURB STOP
-  GATE VALVE
-  PRESSURE REDUCER
-  WATER MAIN
-  SERVICE LINE
-  PROPERTY LINES
-  ROADS

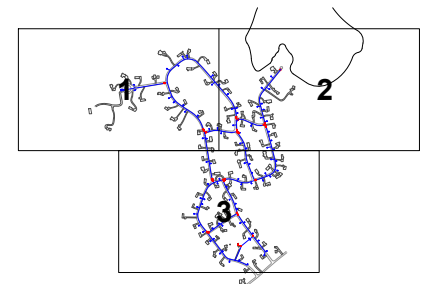

KEY PLAN
1:1000

NOTE: THESE DRAWINGS WERE PRODUCED
USING HARDCOPY MAPS PROVIDED BY OTHERS.
THE LOCATION INFORMATION SHOWN HAS NOT
BEEN LOCATED BY SURVEY.

MATCH LINE DWG NO. 3

0 50 100 200 300
SCALE: 1" = 100'



ABENAKI WATER COMPANY









SCALE: 1" = 100'	DRAWN BY: LHB
DATE: AUGUST 2019	CHECKED BY: RJG


WHITE ROCK SYSTEM MAPPING

DRAWING FILE:
DRAWING NO.: 2 OF 3

MATCH LINE DWG NO. 1

Redacted

-  HYDRANT
-  CURB STOP
-  GATE VALVE
-  PRESSURE REDUCER
-  WATER MAIN
-  SERVICE LINE
-  PROPERTY LINES
-  ROADS

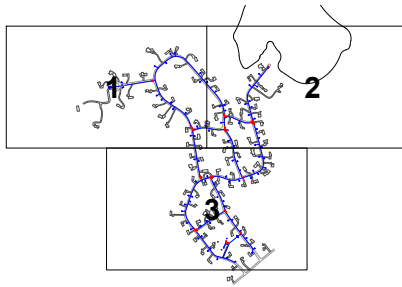

KEY PLAN
1:1000

NOTE: THESE DRAWINGS WERE PRODUCED
USING HARDCOPY MAPS PROVIDED BY OTHERS.
THE LOCATION INFORMATION SHOWN HAS NOT
BEEN LOCATED BY SURVEY.

0 50 100 200 300
SCALE: 1" = 100'



ABENAKI WATER COMPANY

SCALE: 1" = 100'	DRAWN BY: LB/RG
DATE: AUGUST 2019	CHECKED BY: DV

WHITE ROCK SYSTEM MAPPING

DRAWING FILE:
DRAWING NO.: 2 OF 3